



**INDEPENDENCE
EXCAVATING**

A DIGeronimo Company

Cover letter for
241414 Stonecrest Business Park
Cross Sections & Profiles

Items attached to this cover letter:



- Profile sheet for Stonecrest Business Park "Road A" provided by GAI Consultants with asbuilt information (Sheet 18 of 45 – 42"x 30")
- Cross Section Views for Stonecrest Business Park for "Road A" provided by GAI Consultants with asbuilt information (Sheet 19 of 42– 42"x 30")

All items listed above shall be considered sealed via the State of Pennsylvania Registered Land Surveyor stamp and signature affixed to this cover letter.


Zachary Hayes

Digitally signed by Zachary
Hayes
DN: C=US,
E=zhayes@indexc.com,
O=Independence
Excavating, CN=Zachary
Hayes
Reason: I attest to the
accuracy and integrity of this
document.
Date: 2026.01.07
15:03:14-05'00'



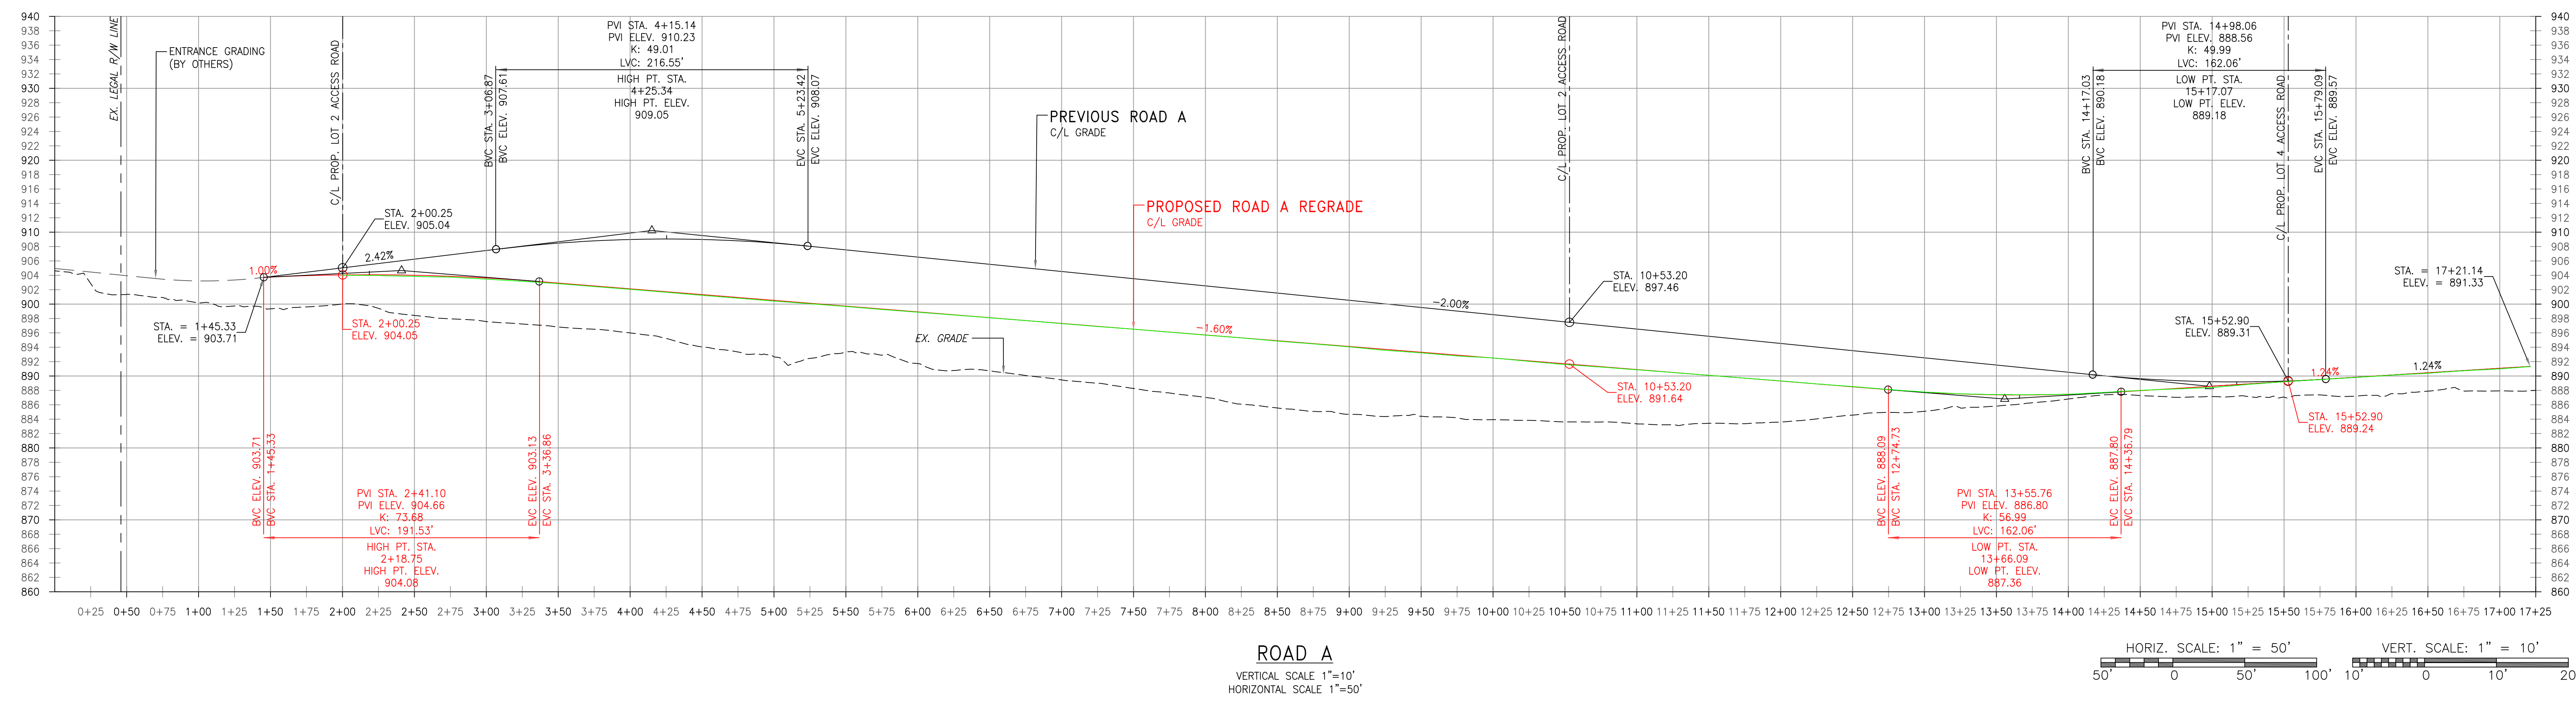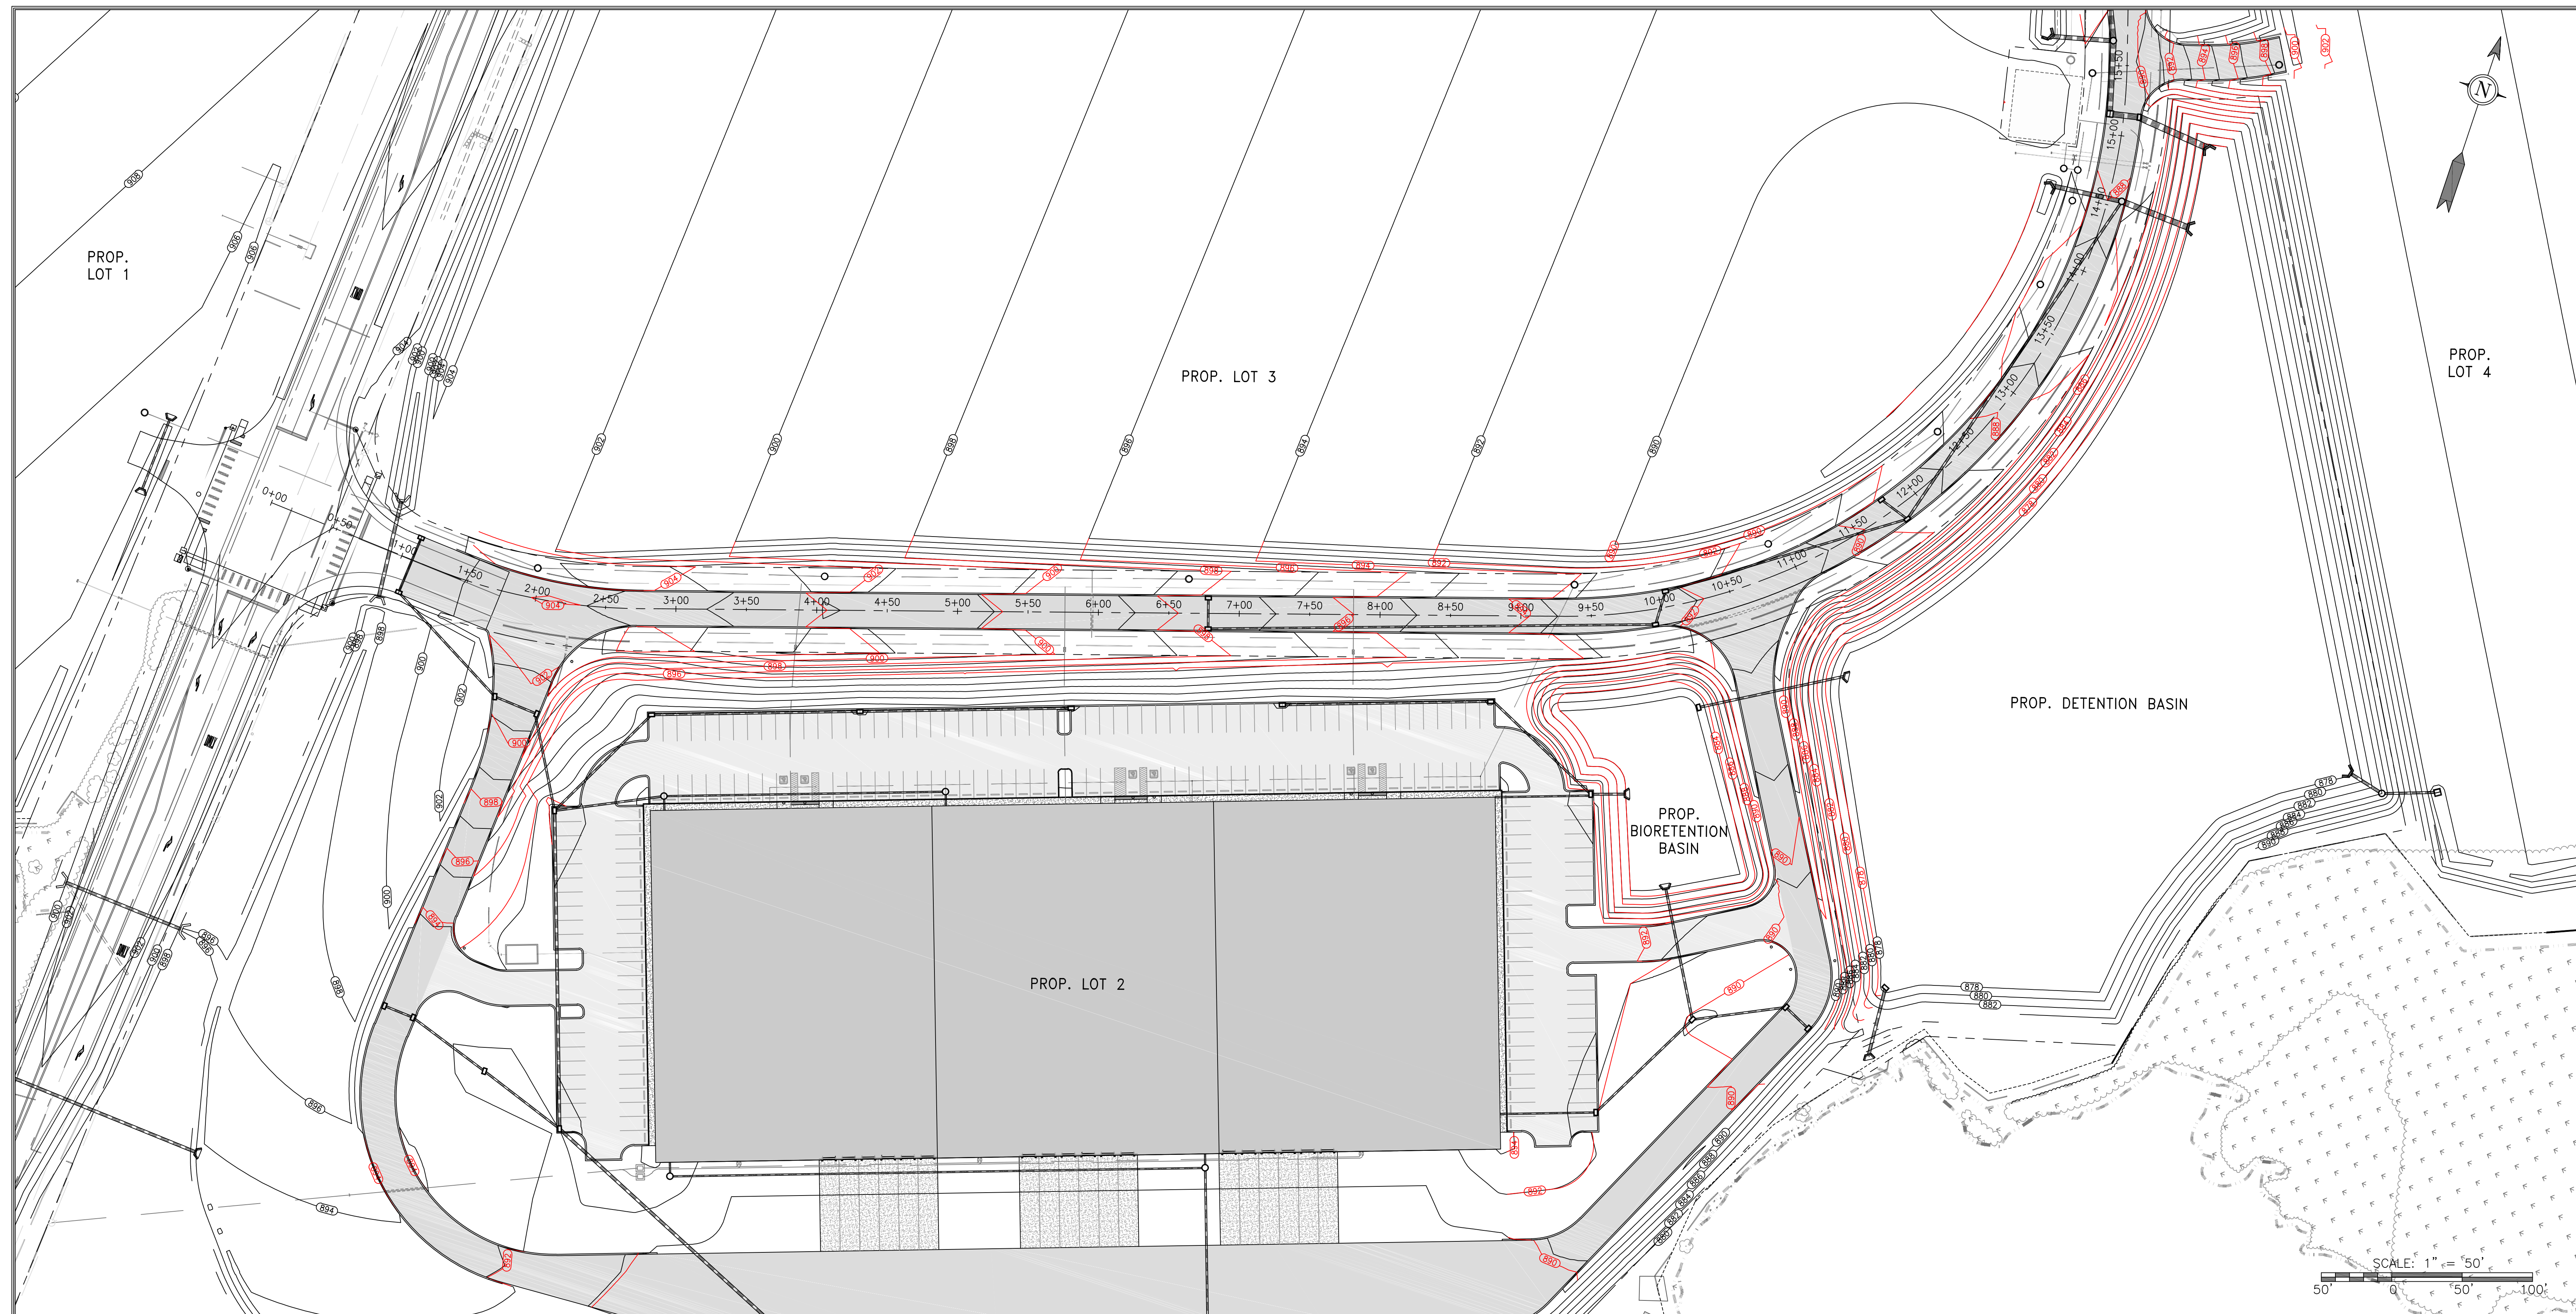


This drawing was produced with computer aided drafting technology and is supported by electronic drawing files. Do not reuse this drawing via manual drafting methods.
 08_CAD FILE PATH: Z:\3300\330010504 - LSC\44-55 Site-Plan-CAD\330010504.dwg - Corinn Behr CAD File - Production\Road Network\330010504-02-04-01-C-41-Profile.dwg
 PLOTTED ON: 3/15/2012 1:38:49 PM PLOTTED BY: Corinn S. Behr ELOT FILE: US STANDARDS
 ic nsult nts

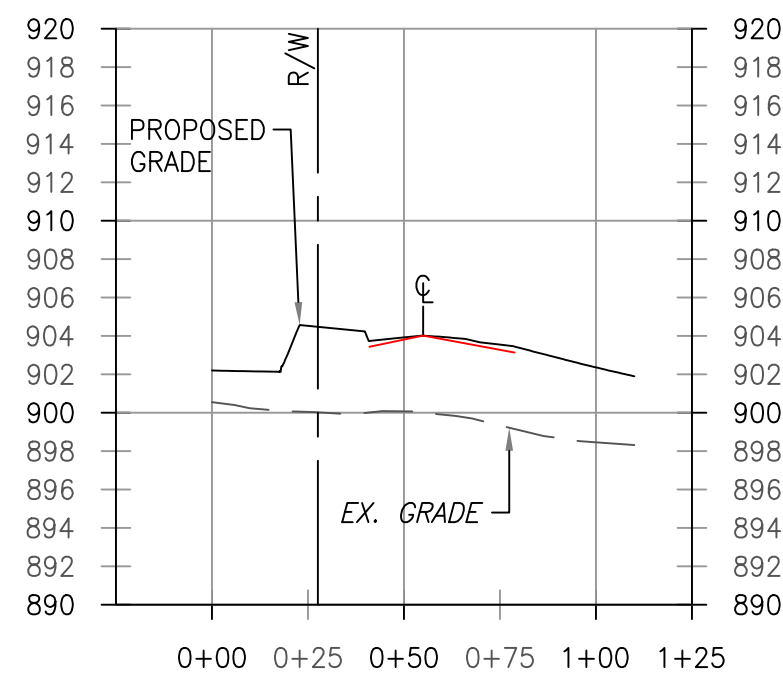


900.5
902.19
900.0
904.52
900.7
903.92
899.3
903.54
898.5
902.35

XS 2+00
VERTICAL SCALE 1"=10'
HORIZONTAL SCALE 1"=50'

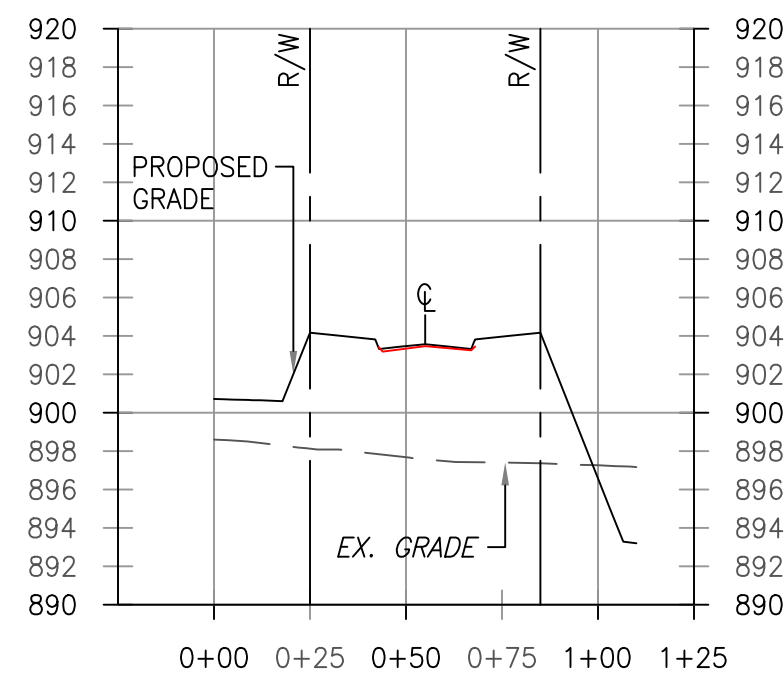


898.6
900.71
898.7
904.16
897.7
903.46
897.4
903.96
897.7
896.58

XS 3+00
VERTICAL SCALE 1"=10'
HORIZONTAL SCALE 1"=50'

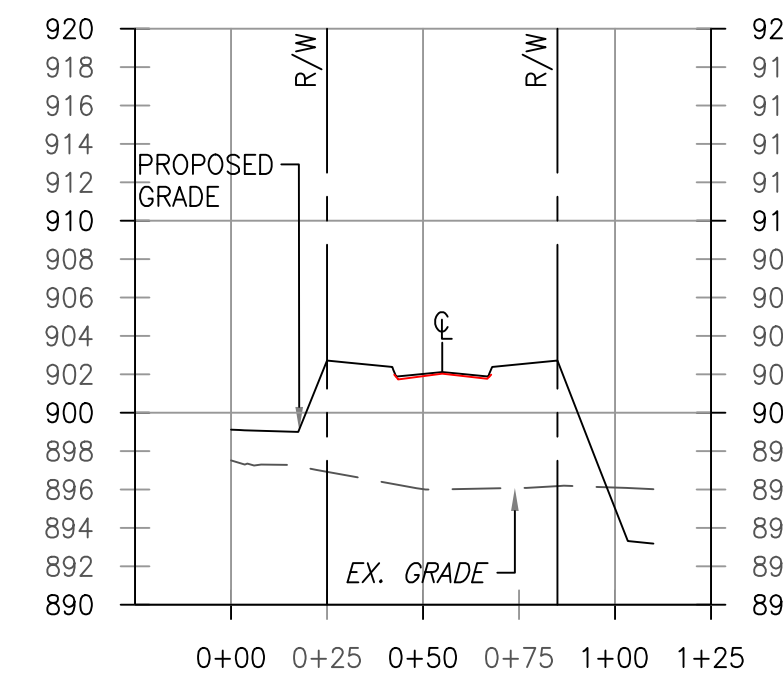


897.5
899.11
896.9
902.72
902.02
896.7
902.52
896.1
895.03

XS 4+00
VERTICAL SCALE 1"=10'
HORIZONTAL SCALE 1"=50'

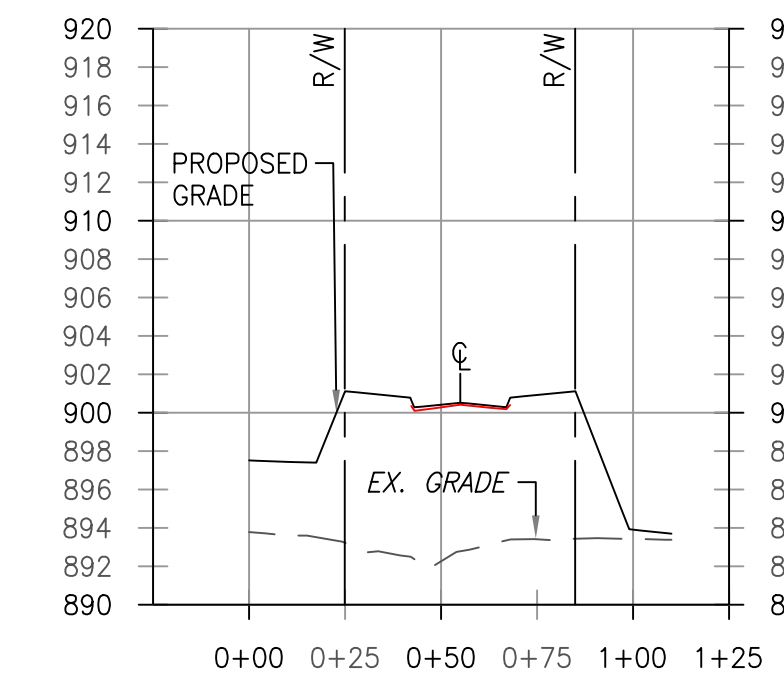


893.8
897.50
893.2
901.11
900.41
893.4
900.81
893.4
893.91

XS 5+00
VERTICAL SCALE 1"=10'
HORIZONTAL SCALE 1"=50'

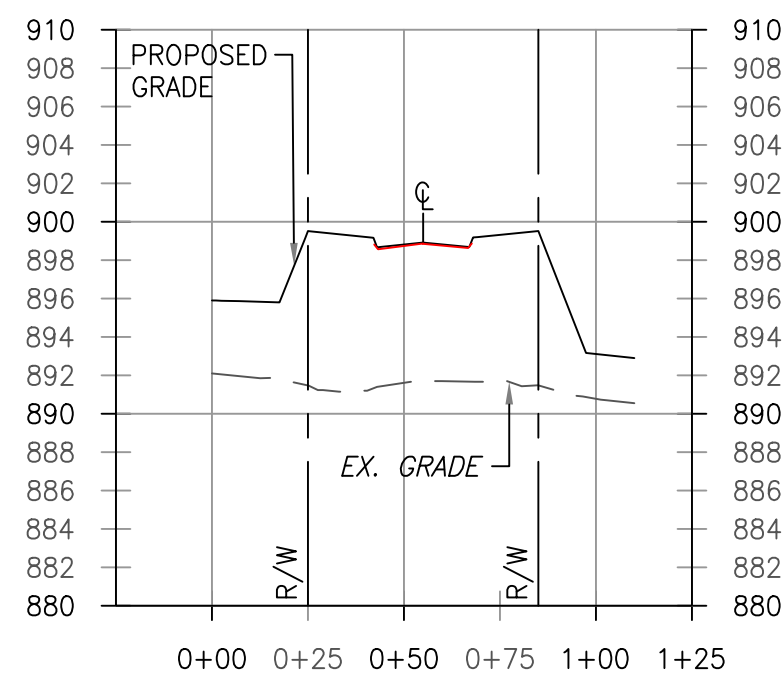


892.7
895.90
891.5
893.51
897.6
896.81
897.7
899.31
899.8
893.11

XS 6+00
VERTICAL SCALE 1"=10'
HORIZONTAL SCALE 1"=50'

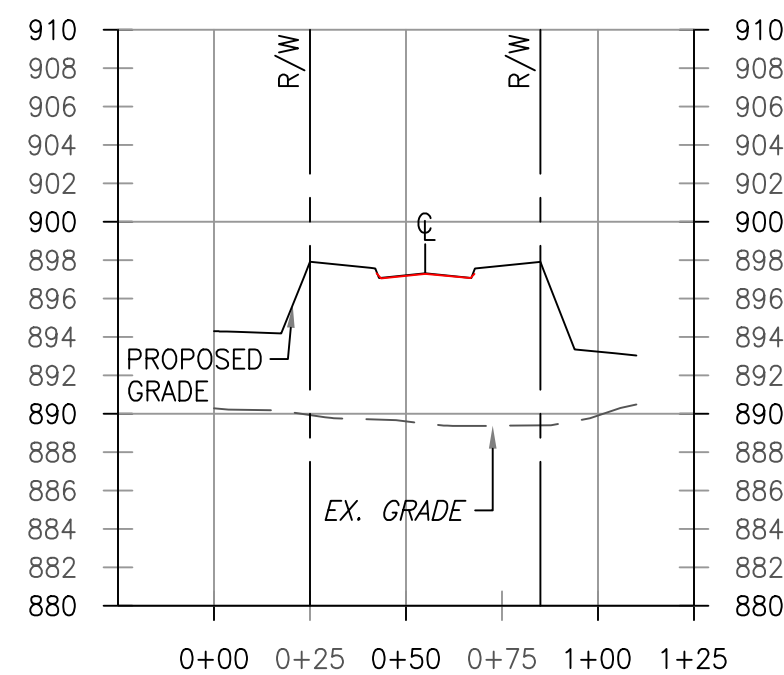


890.3
894.30
899.9
897.91
899.6
897.21
899.4
897.71
899.2
893.23

XS 7+00
VERTICAL SCALE 1"=10'
HORIZONTAL SCALE 1"=50'

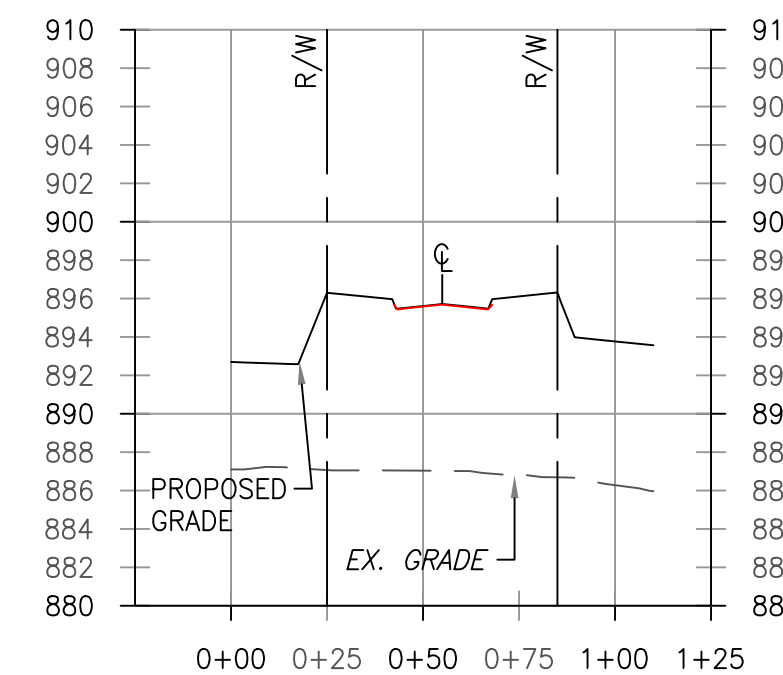


887.7
892.69
887.7
896.30
895.60
896.8
896.11
896.3
893.76

XS 8+00
VERTICAL SCALE 1"=10'
HORIZONTAL SCALE 1"=50'

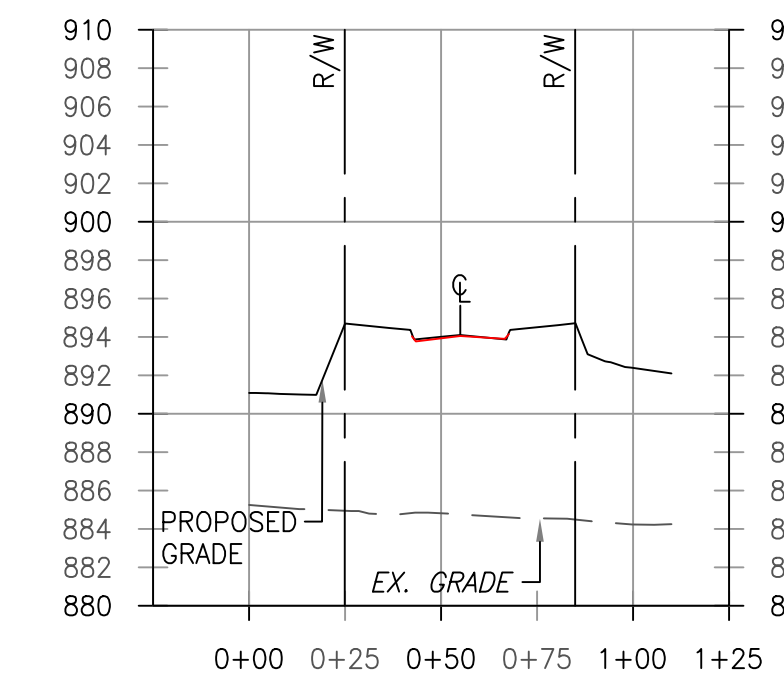


886.2
891.09
894.70
894.00
894.5
894.50
894.2
892.38

XS 9+00
VERTICAL SCALE 1"=10'
HORIZONTAL SCALE 1"=50'

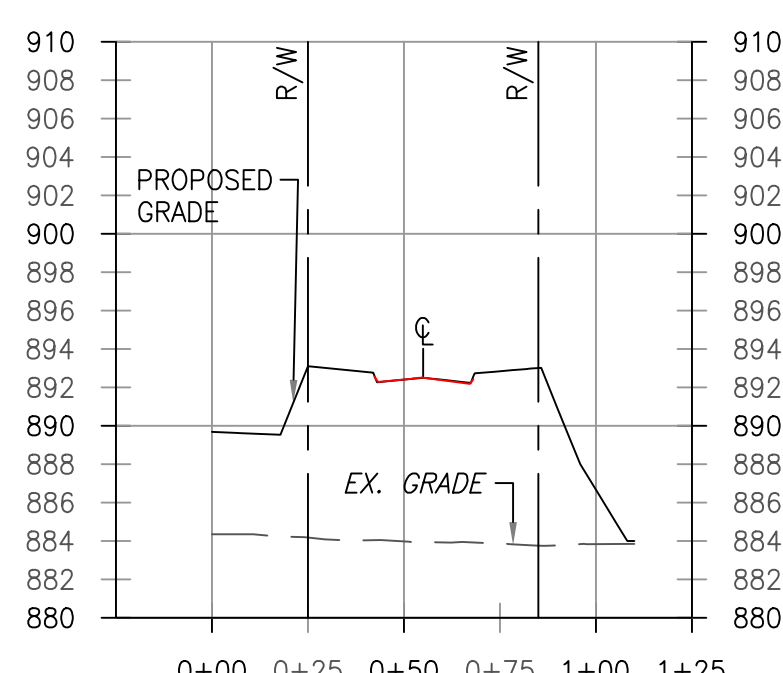


884.2
889.68
884.2
893.10
894.0
892.40
892.84
892.8
886.66

XS 10+00
VERTICAL SCALE 1"=10'
HORIZONTAL SCALE 1"=50'

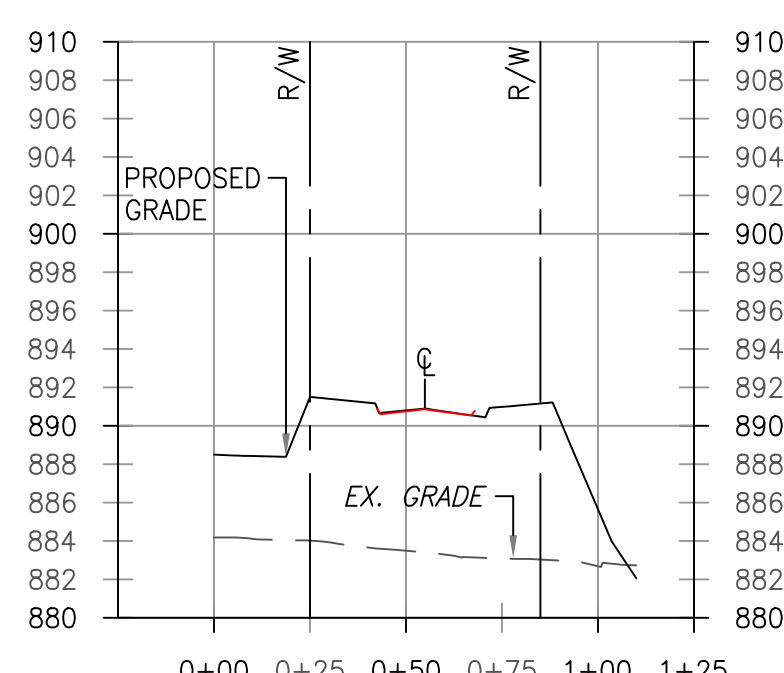


894.2
895.50
894.0
891.91
892.5
890.80
893.7
890.98
892.7
885.66

XS 11+00
VERTICAL SCALE 1"=10'
HORIZONTAL SCALE 1"=50'

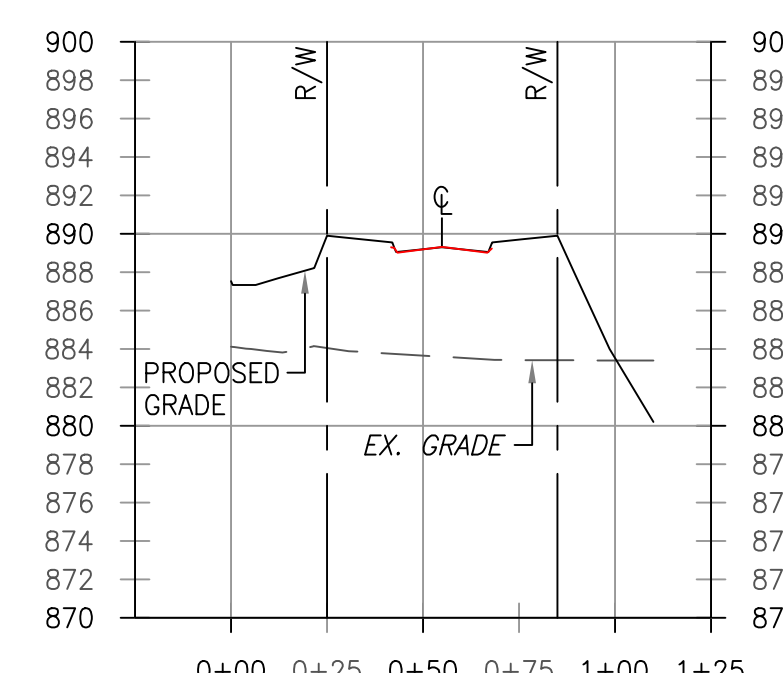


884.7
887.53
884.0
889.89
887.7
889.19
892.4
889.69
882.4
883.53

XS 12+00
VERTICAL SCALE 1"=10'
HORIZONTAL SCALE 1"=50'

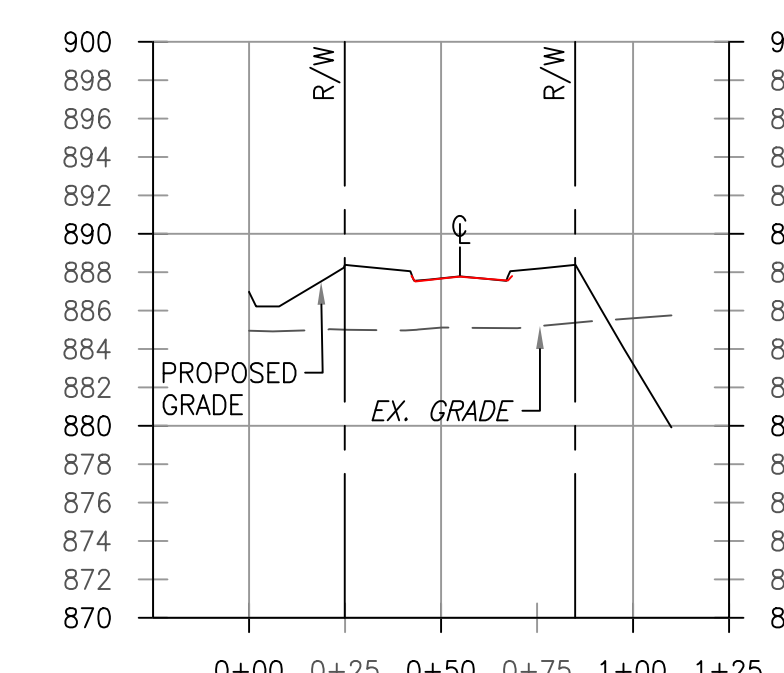


884.9
886.99
895.0
885.36
887.05
885.2
888.18
885.6
883.24

XS 13+00
VERTICAL SCALE 1"=10'
HORIZONTAL SCALE 1"=50'

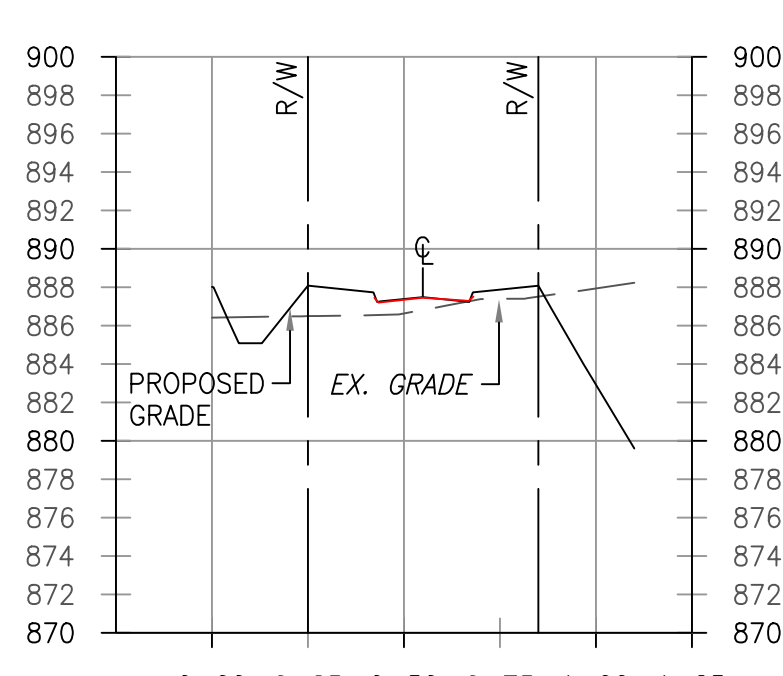


886.4
888.02
886.5
888.07
886.6
887.36
887.4
887.87
887.9
882.93

XS 14+00
VERTICAL SCALE 1"=10'
HORIZONTAL SCALE 1"=50'

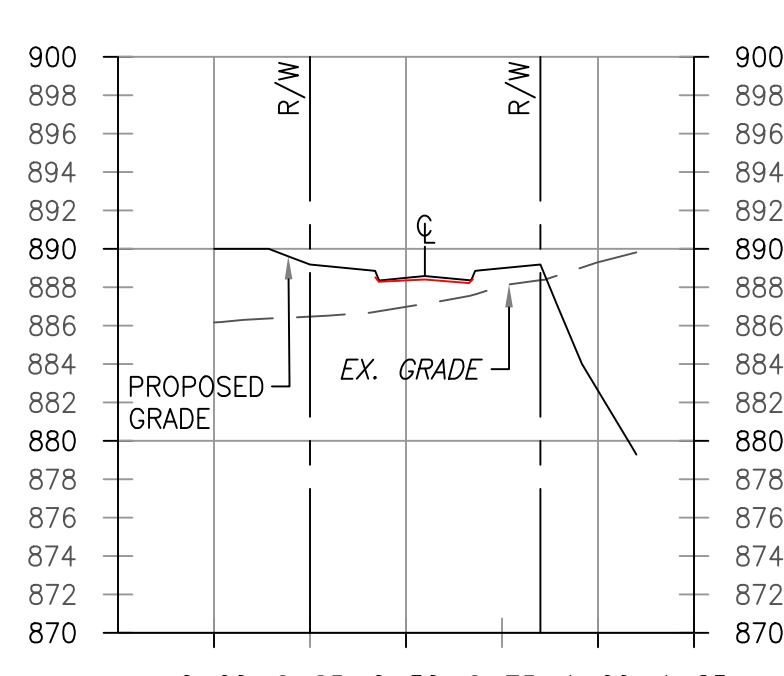


886.2
890.00
886.5
889.18
887.0
888.49
889.7
889.98
889.7
882.61

XS 15+00
VERTICAL SCALE 1"=10'
HORIZONTAL SCALE 1"=50'

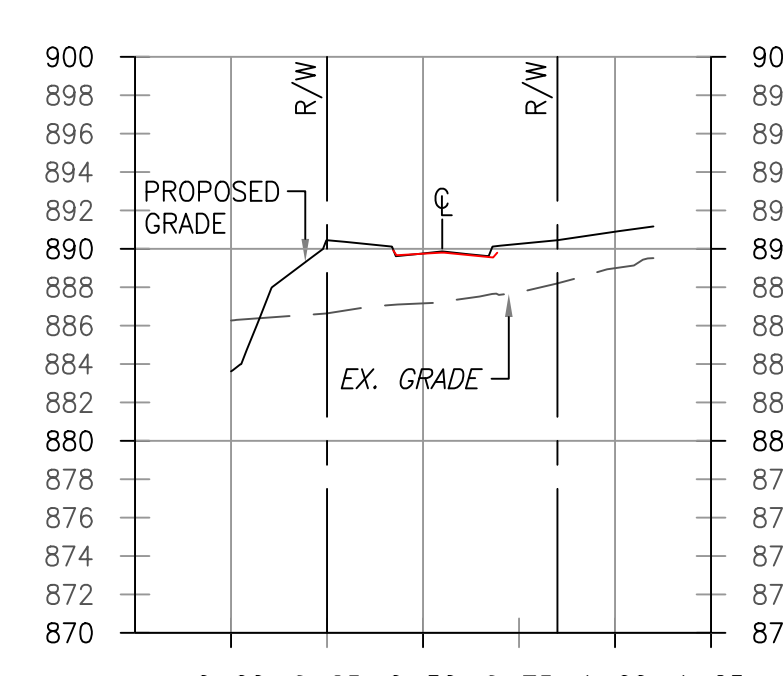


886.3
883.61
886.6
890.45
887.2
889.76
887.7
890.25
889.0
890.88


XS 16+00
VERTICAL SCALE 1"=10'
HORIZONTAL SCALE 1"=50'

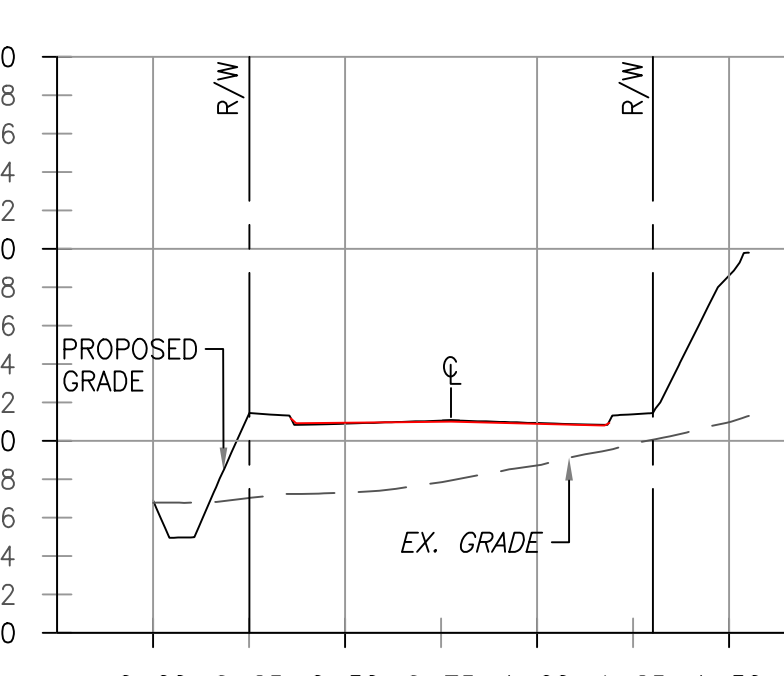


886.8
886.89
887.0
891.39
890.89
887.3
887.8
891.05
886.7
890.92
889.8
891.38
891.0
888.60

XS 17+00
VERTICAL SCALE 1"=10'
HORIZONTAL SCALE 1"=50'

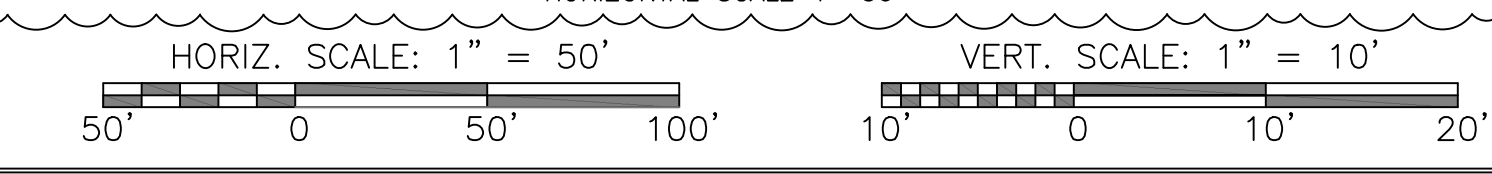



ic result nts

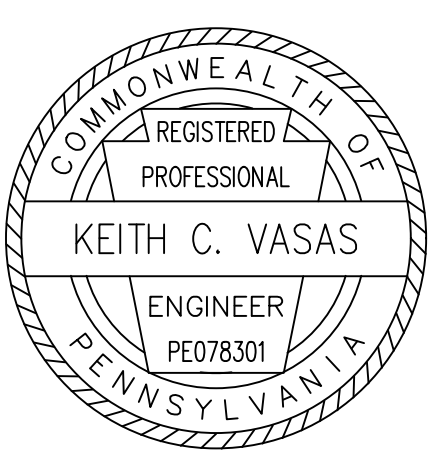

KEITH C. VASAS
REGISTERED PROFESSIONAL ENGINEER
PE078301
PENNSYLVANIA

COMMONWEALTH OF PENNSYLVANIA

REGISTERED PROFESSIONAL ENGINEER

PE078301

PENNSYLVANIA

REGISTERED PROFESSIONAL ENGINEER

PE078301

PENNSYLVANIA

REGISTERED PROFESSIONAL ENGINEER

PE078301